


E-PLANS APPROVAL



CLIENT:
WOODFIELD INVESTMENTS
3403 Cummings Lane
Chevy Chase, MD 20815
(301) 789-2045
WWW.WFIELDV.NET

CONSULTANT:
D

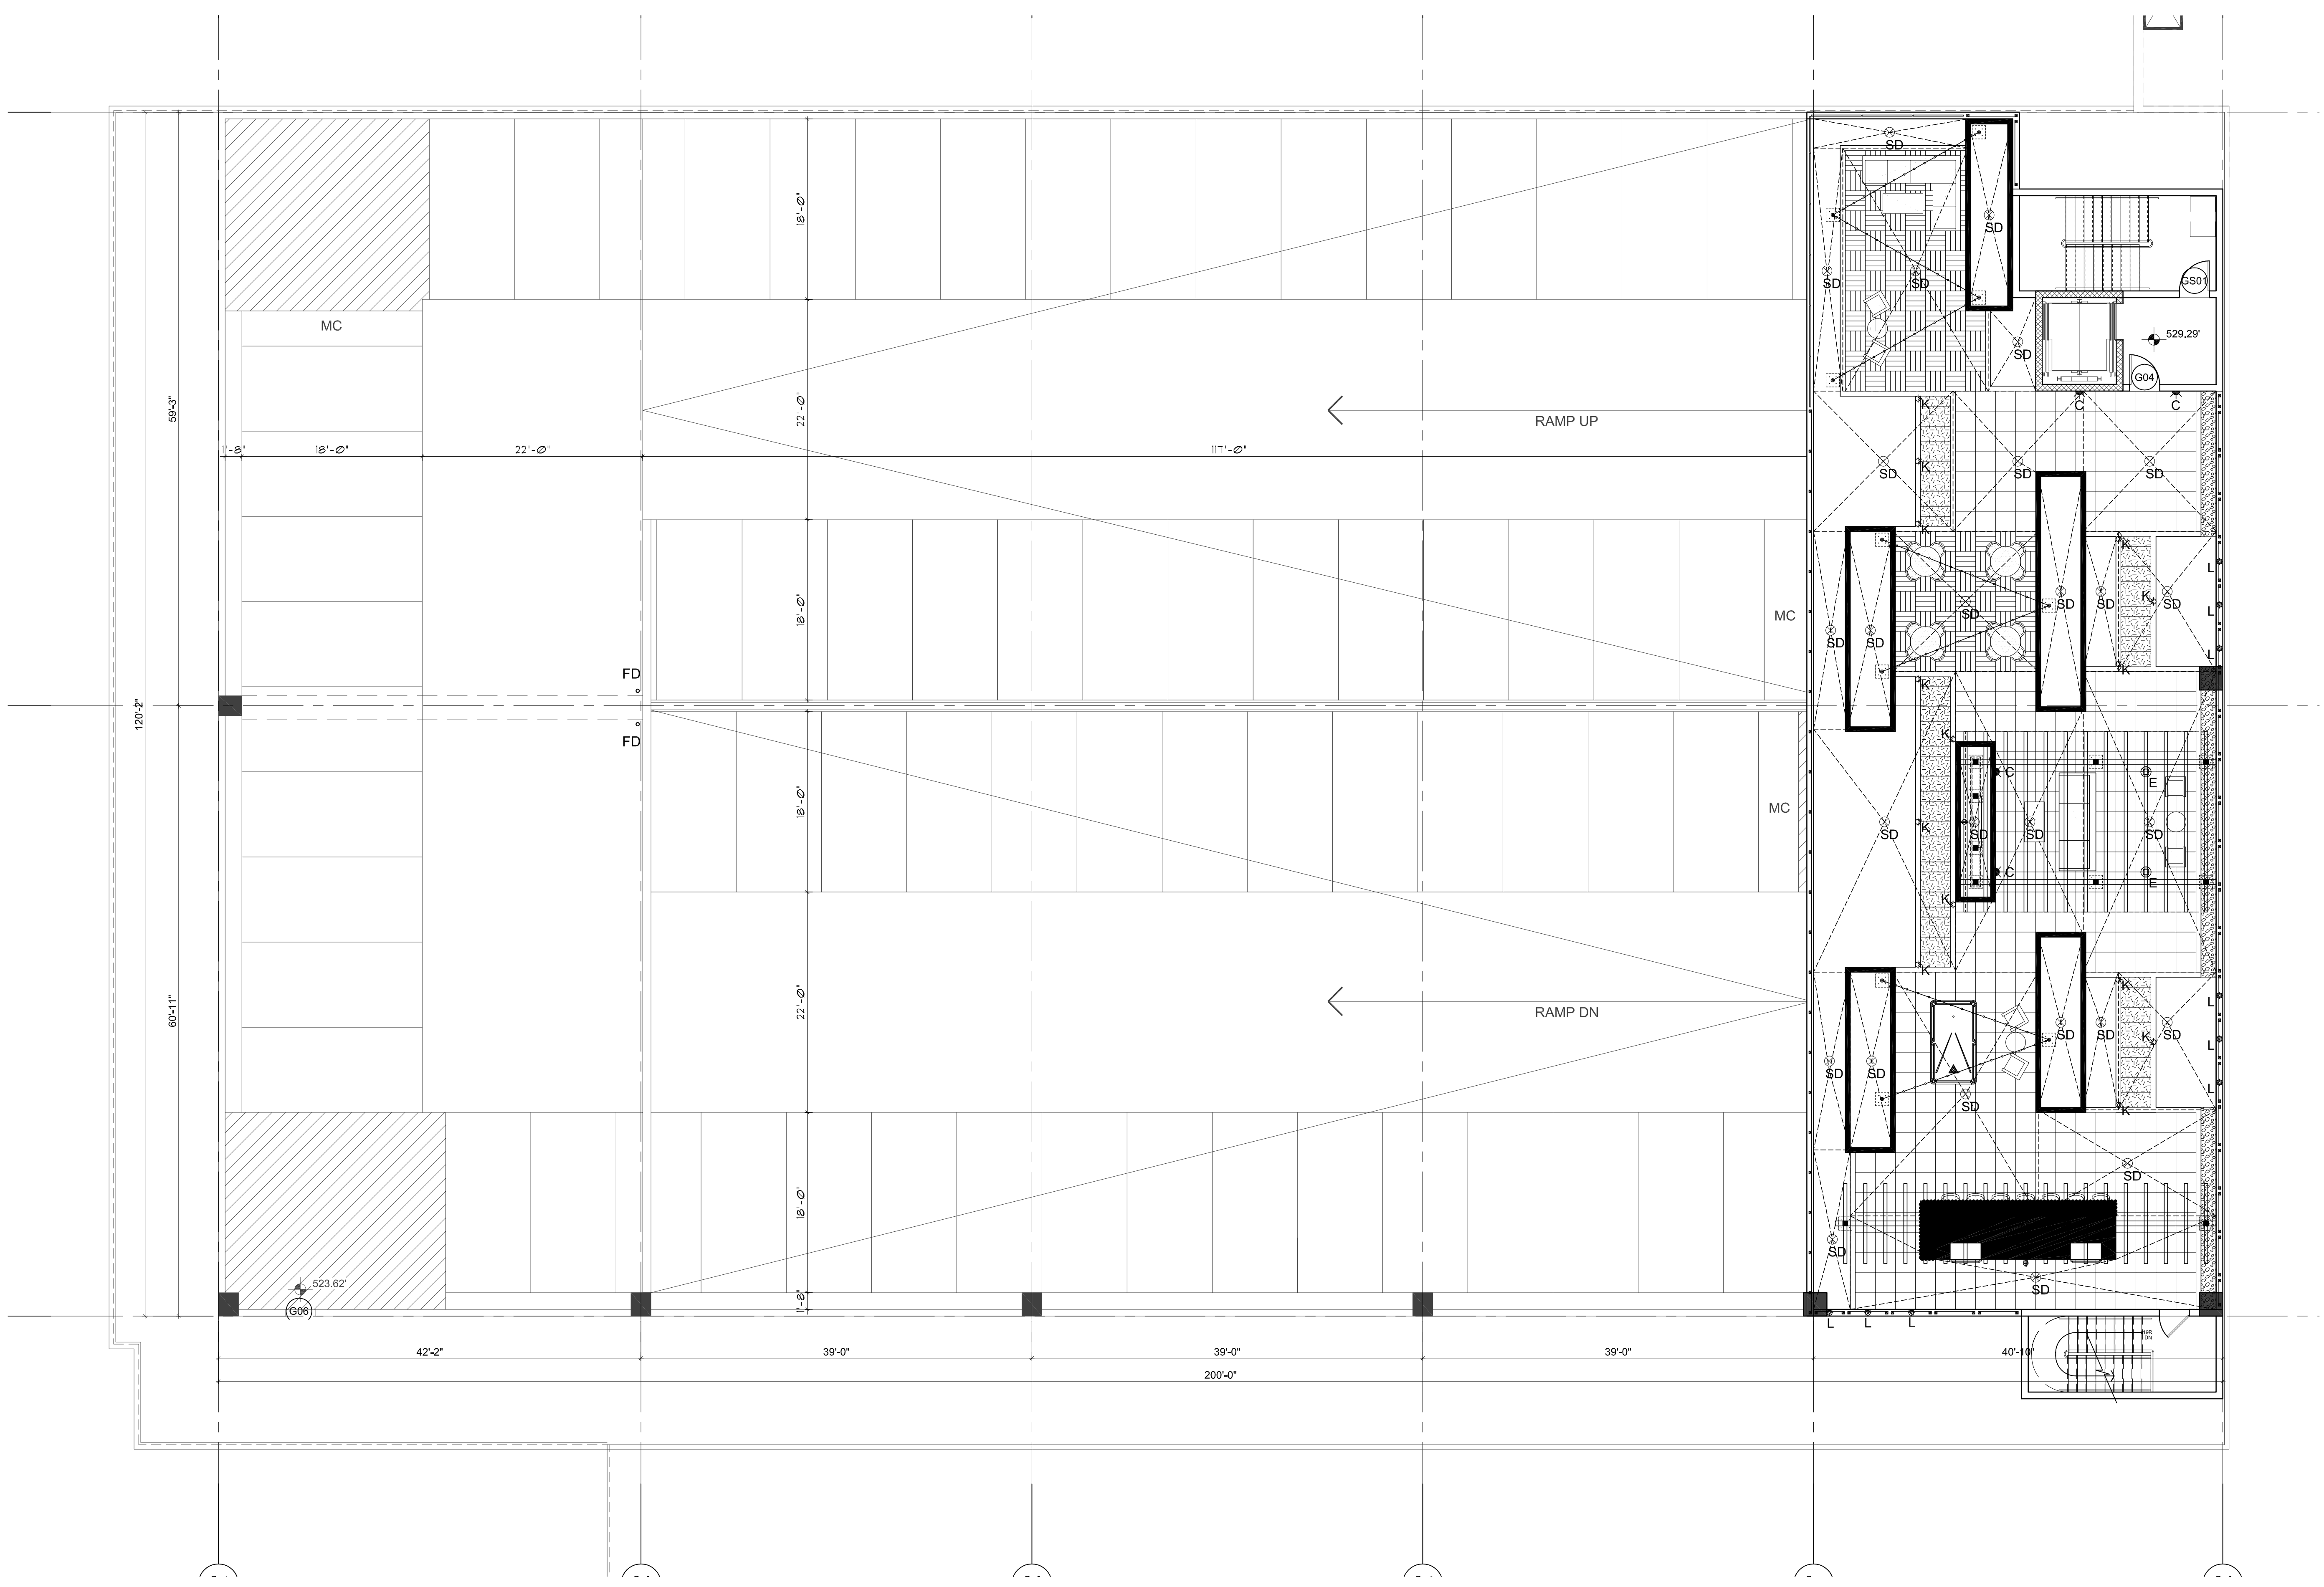

**MALLORY SQUARE
BUILDING A**
SITE PLAN NUMBER: 820120130
ROCKVILLE, MD
CLIENT: WOODFIELD INVESTMENTS

REV	DATE	DESCRIPTION
1	02/17/15	SITE PLAN SUBMISSION AMENDMENT B
2	02/17/15	SITE PLAN SUBMISSION FOR SIGNATURE
3	02/20/15	INITIAL CIP SUBMISSION
4	02/17/15	CERTIFIED PRE-PLAN SUBMISSION
1	02/15/12	REVISION PER REVIEWER COMMENT
2	02/07/12	REVISED LAYOUT
3	02/07/12	REVISION PER REVIEWER COMMENT
REV	DATE	DESCRIPTION

**SITE PLAN
SUBMISSION
DELIVERABLE: AMENDMENT B**
ISSUE DATE: 2.13.2015

PROJECT NUMBER: 20100650.02
DRAWN BY: BF
CHECKED BY:

Copyright © 2015 by KTG GROUP, Inc. All Rights Reserved.
SHEET TITLE:
G106 GARAGE LEVEL

DEVELOPER'S CERTIFICATE
The undersigned agrees to execute all the features of the Site Plan Approval No. 820120130, including Approval Conditions, Development Program, and Certified Site Plan.
Developer's Name: Mallory Square Partners I, LLC.
Contact Person: Margaret Smith Ford
Address: 3403 Cummings Lane, Maryland 20815
Phone: 301.789.2045
Signature: Margaret Smith Ford

1 G106 GARAGE LEVEL
1/8" = 1'-0" ELEV. = 529.29'

- List of Amendment items for 82012013B
1. Install additional amenities and furniture on roof of approved garage for building A.
 2. Relocation of SWM facilities from between garage and MF building, to ground level, and adjustment of plant material in those locations.
 3. Loss of one residential unit, affecting floor plans.

T:\Mallory Square\Building A\3201-Units\A327.dwg 3/4/2015 12:41:43 PM